


SWEDE ROAD

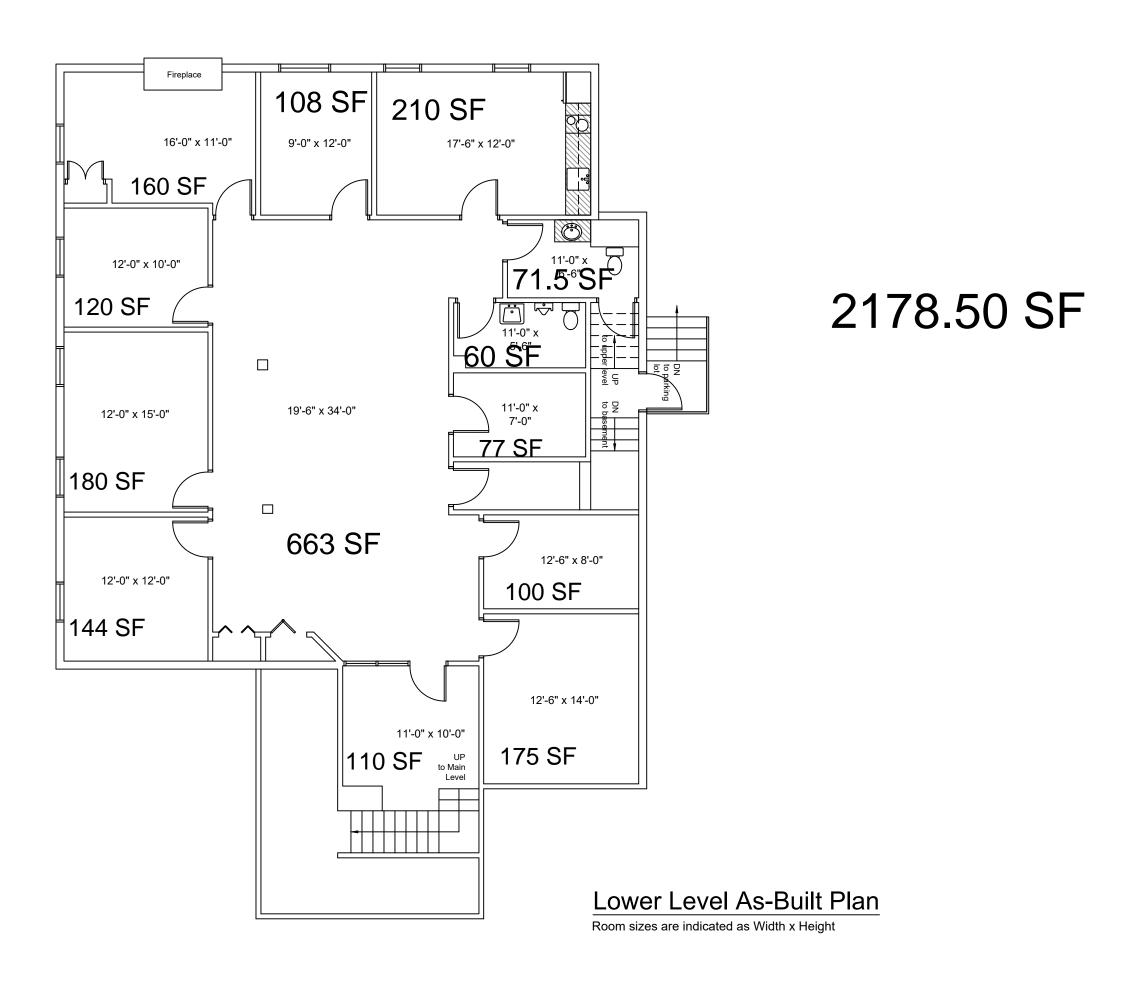

1780 Swede Road Blue Bell, PA 19422 Total SF - 5,783.50

Project #RPS2022-150 1/8"=1'-0" when printed on 36x24sheet

11.15.22 10:42 AM Preliminary As-Built issued 11.17.22 As-Built issued. Builiding orientation revised from 11.15 plan

## InterState

COMMERCIAL

